


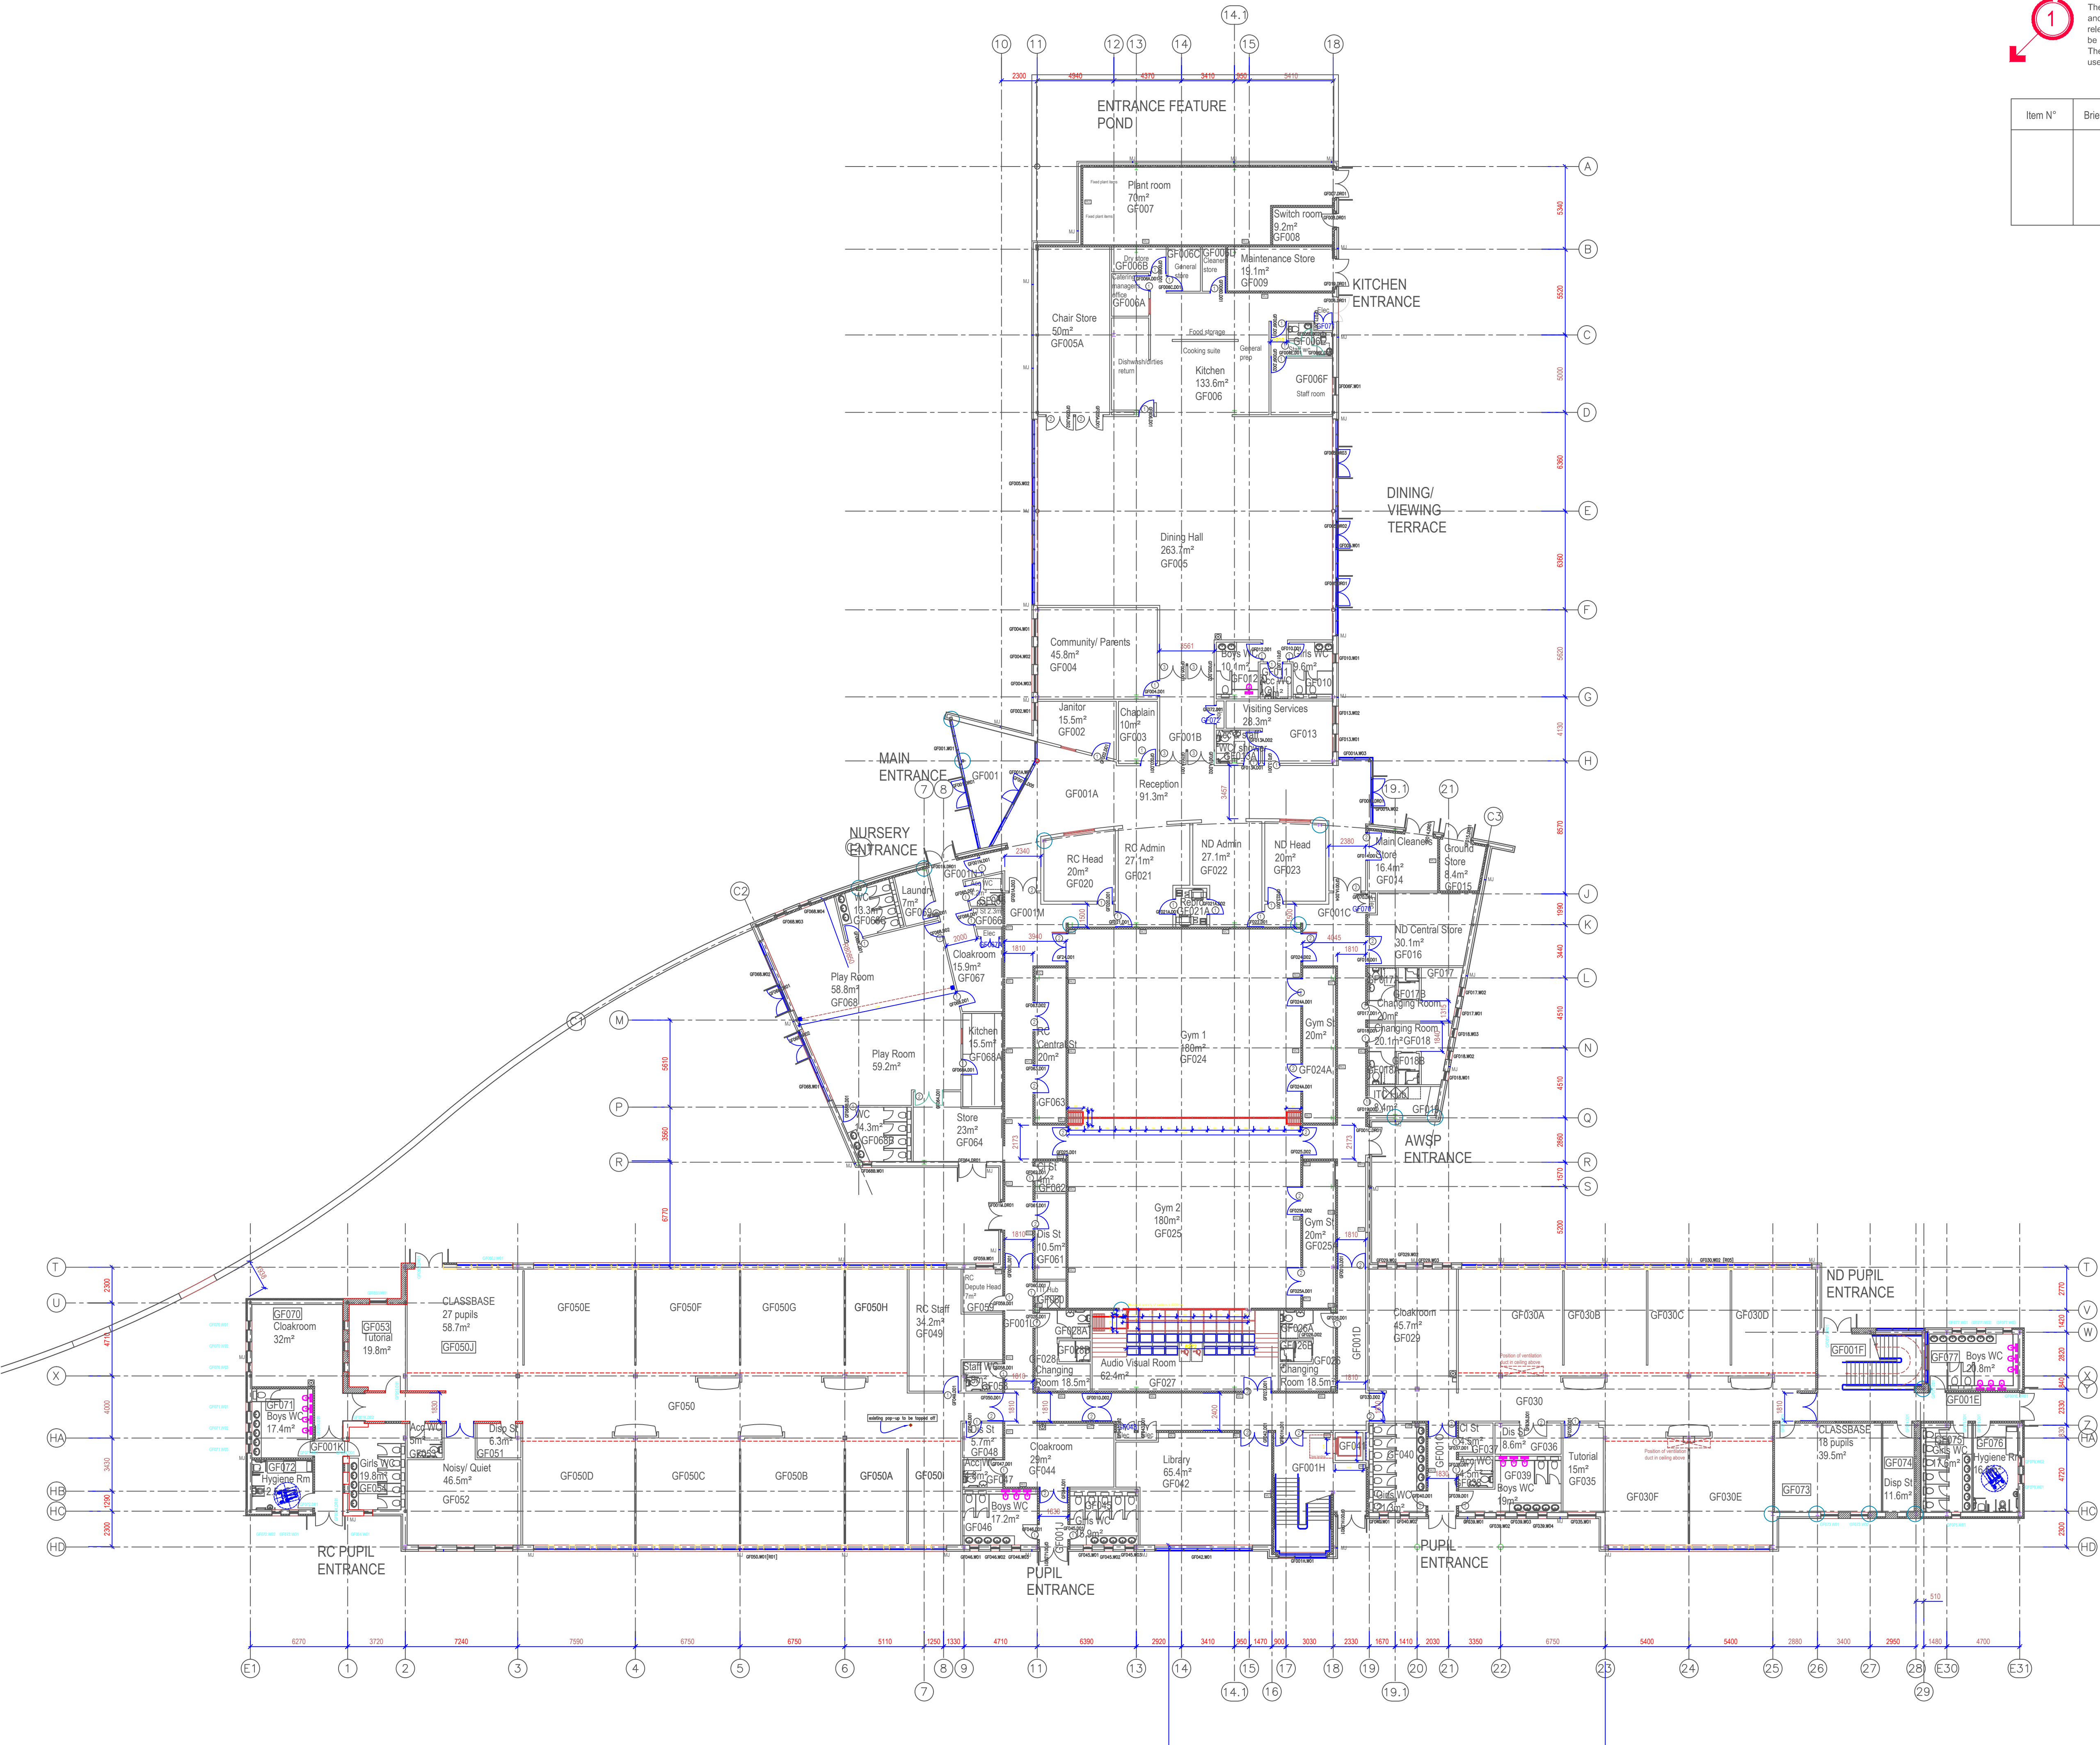

HEALTH & SAFETY ALERT
CONSTRUCTION (DESIGN & MANAGEMENT) REGULATIONS 1994
The designs on this drawing are prepared with the consideration of the need to identify hazards and give regard to the hierarchy of risk control. The drawing is to be read in conjunction with the relevant Designers Risk Assessment and the contractors Risk Register. Reference should also be made to the Construction Phase Health & Safety Plan prepared by the Principal Contractor. The following list highlights hazards identified during the design process for the benefit of all users of this drawing and is not exhaustive.

Item N°	Brief Description	Date Inserted	Inserted By	Checked By

- NOTES:
- The external and internal structural walls have been block shaded. To see what is contained within the original scheme see drawings B19_AB_L(00)01_001 and B19_AB(00)02_001
 - Rooms that have been revised or added are shown with a rectangle around the room number.
 - Certain windows have been indicated that occur at braced positions; these windows may require to be amended.
 - For details of fire resisting structures, compartmentation, escape distances etc refer to drawing no. B19.1_PD_L(26)0_001 for details
 - Laminated or toughened safety glazing will be incorporated in compliance with the requirements of BS 6262: Part 4: 2005.
 - All electrical installation to comply with the relevant requirements of BS7671:2001 or equivalent standards, see m&e drawings.

DOOR WIDTHS [Clear opening]
refer to circled numbers at doors.

- ① 878mm
② 1628mm

rev	description	date	dr by	sp by
original by	EMcA	August 2008	RB	



Working in Partnership
Education 2010 PPP



Aedas
Aedas Architects
Aedas Architects Ltd
Floor 9 Cadogan Square
Cadogan Street
Glasgow G2 7HF
United Kingdom
T +44(0)141 2250555
F +44(0)141 2487923
E glasgow@aedas.com
aedas.com



project B19.1 Wishaw Academy / St Ignatius Primary School		
drawing Proposed Extended Ground floor plan		
computer file	plot date	
project number 2002.1659.114	scale 1:200	
drawing number B19.1_AB_L(00)01_001	rev -	issue status AS BUILT
This drawing is to be read in conjunction with all related drawings. Do not scale from this drawing. All dimensions must be checked and verified on site before commencing any work or producing shop drawings. The originator should be notified immediately of any discrepancy. This drawing is copyright and remains the property of Aedas.		